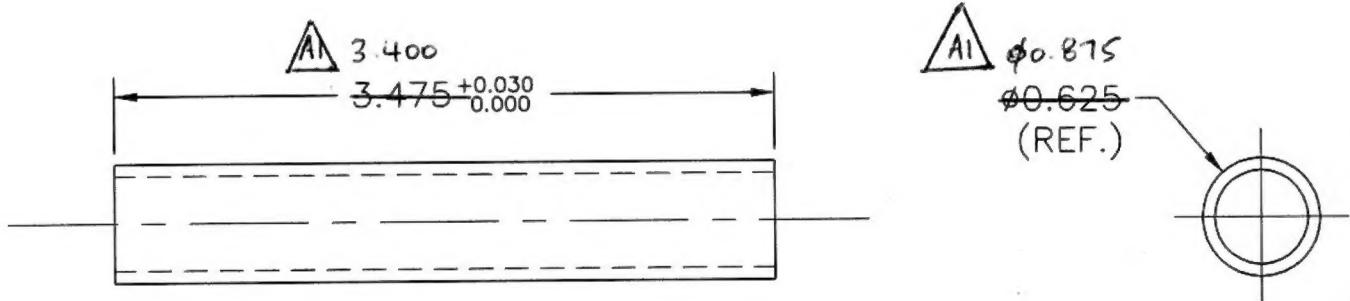


**DART**

DESIGN <i>RF</i>	DRAWN BY <i>RF</i>	DART AEROSPACE USA, INC. BELLEVUE, WA	
CHECKED <i>[Signature]</i>	APPROVED <i>[Signature]</i>	DRAWING NO. D2971	REV. A SHEET 1 OF 1
DATE 00.03.13		TITLE CROSS BOLT SPACER	SCALE 1:1
A	00.03.13	NEW ISSUE	
A1	<del>41 UP</del> 02-10-30	CHANGE TO 0.875 DD * 0.058 WALL	

**RELEASED**  
00.05.11 

MATERIAL: 6061-T6 (WW-T-700/6) ~~0.625 DIA. x 0.065 WALL~~  
TOLERANCES ARE PER DART QSI 018 UNLESS OTHERWISE NOTED

0.875 DIA \* 0.058 WALL